

METUCHEN PET CLUB
●
279 CENTRAL AVE #A
METUCHEN NJ 08840


PROJECT:

**METUCHEN
PET-CLUB
METUCHEN-NJ**

AS-BUILT

SEAL & SIGNATURE: _____
DATE: 8/14/2021
SCALE: 1/4"=1'-0"
PROJ. NO: 2020-08
DRAWN BY: GG
CHK. BY: GG
DWG NO: _____

A-0.00

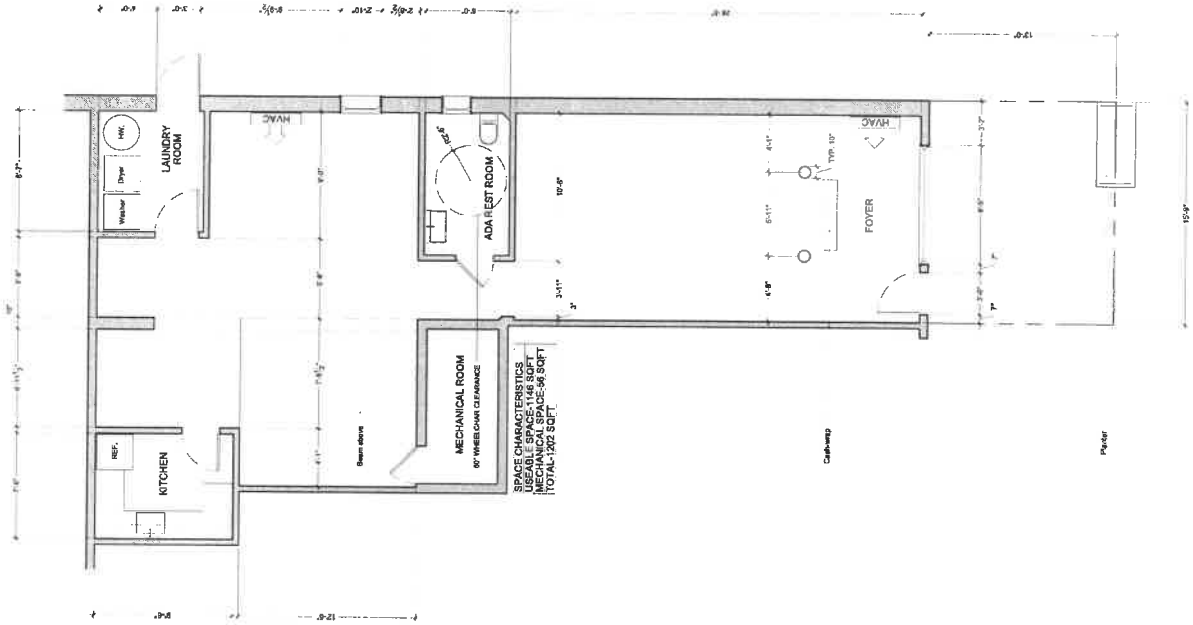

1 AS-BUILT PLAN
SCALE 1/4" = 1'-0"

